


# Circle R Ranch (FPS-1)

## CIRCLE R RANCH PITKIN COUNTY, COLORADO FIRE PROTECTION SYSTEM ALL UTILITIES AND IRRIGATION

### DRAWING INDEX

FPS-1	COVER
FPS-2	VILLAGE WATER AND IRRIGATION - 50 SCALE
FPS-2a	VILLAGE - ALL UTILITIES - 20 SCALE
FPS-2b	VILLAGE - ALL UTILITIES - 20 SCALE
FPS-2c	VILLAGE - ALL UTILITIES - 20 SCALE
FPS-2d	VILLAGE - ALL UTILITIES - 20 SCALE
FPS-3	WATER, UTILITIES AND IRRIGATION - 50 SCALE
FPS-4	WATER, UTILITIES AND IRRIGATION - 50 SCALE
FPS-5	WATER, UTILITIES AND IRRIGATION - 50 SCALE
FPS-6	WATER, TANK, UTILITIES AND IRRIGATION - 50 SCALE
ELEC-1	VILLAGE SHALLOW UTILITIES - 50 SCALE
VPPS-1	VILLAGE POND PUMP STATION
WTP-1	WATER TREATMENT PLANT #1
WTP-2	WATER TREATMENT PLANT #2
WTP-3	WATER TREATMENT PLANT #3
PD-1	PARADISE DITCH DETAILS

NOTE: THIS PROJECT WAS CONSTRUCTED IN CONJUNCTION WITH THE SHALLOW UTILITIES AND IRRIGATION SYSTEM. THE SHALLOW UTILITIES WERE DESIGNED BY PINNACLE ENGINEERING. THE IRRIGATION SYSTEM WAS DESIGNED BY MRL AND PREMIER GREEN.

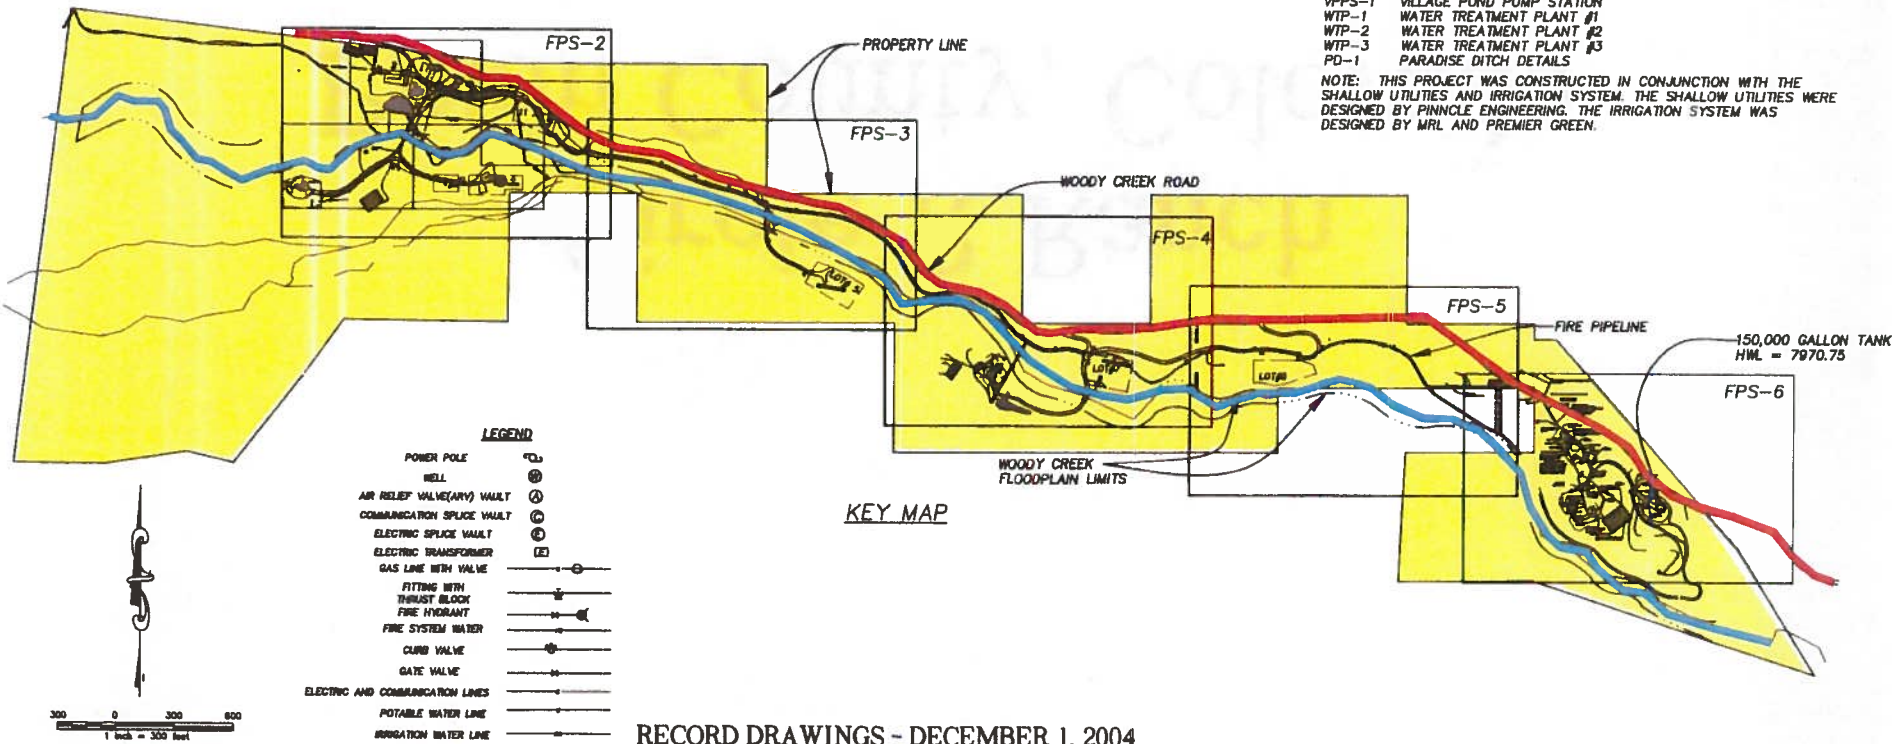

<table border="1"> <tr><td>Number</td><td>Revised</td><td>By</td><td>Date</td></tr> <tr><td>1</td><td>INITIAL UPGRADE</td><td>PL</td><td>12-01-04</td></tr> </table>	Number	Revised	By	Date	1	INITIAL UPGRADE	PL	12-01-04	CIRCLE R RANCH	FIRE PROTECTION SYSTEM	COVER		DESIGN: GDD/AA CHECK: GDD DATE: DECEMBER, 2004	PROJECT NUMBER 03-36-03	Drawing Number: FPS-1
Number	Revised	By	Date												
1	INITIAL UPGRADE	PL	12-01-04												